

67.0

Foreshore Lease Area:


Millstone River

RECEIVED  
AUG 24 2012

Ministry of Forests, Lands  
& Natural Resource Operations  
West Coast Service Centre


*Paula Wallace*

-2.6'

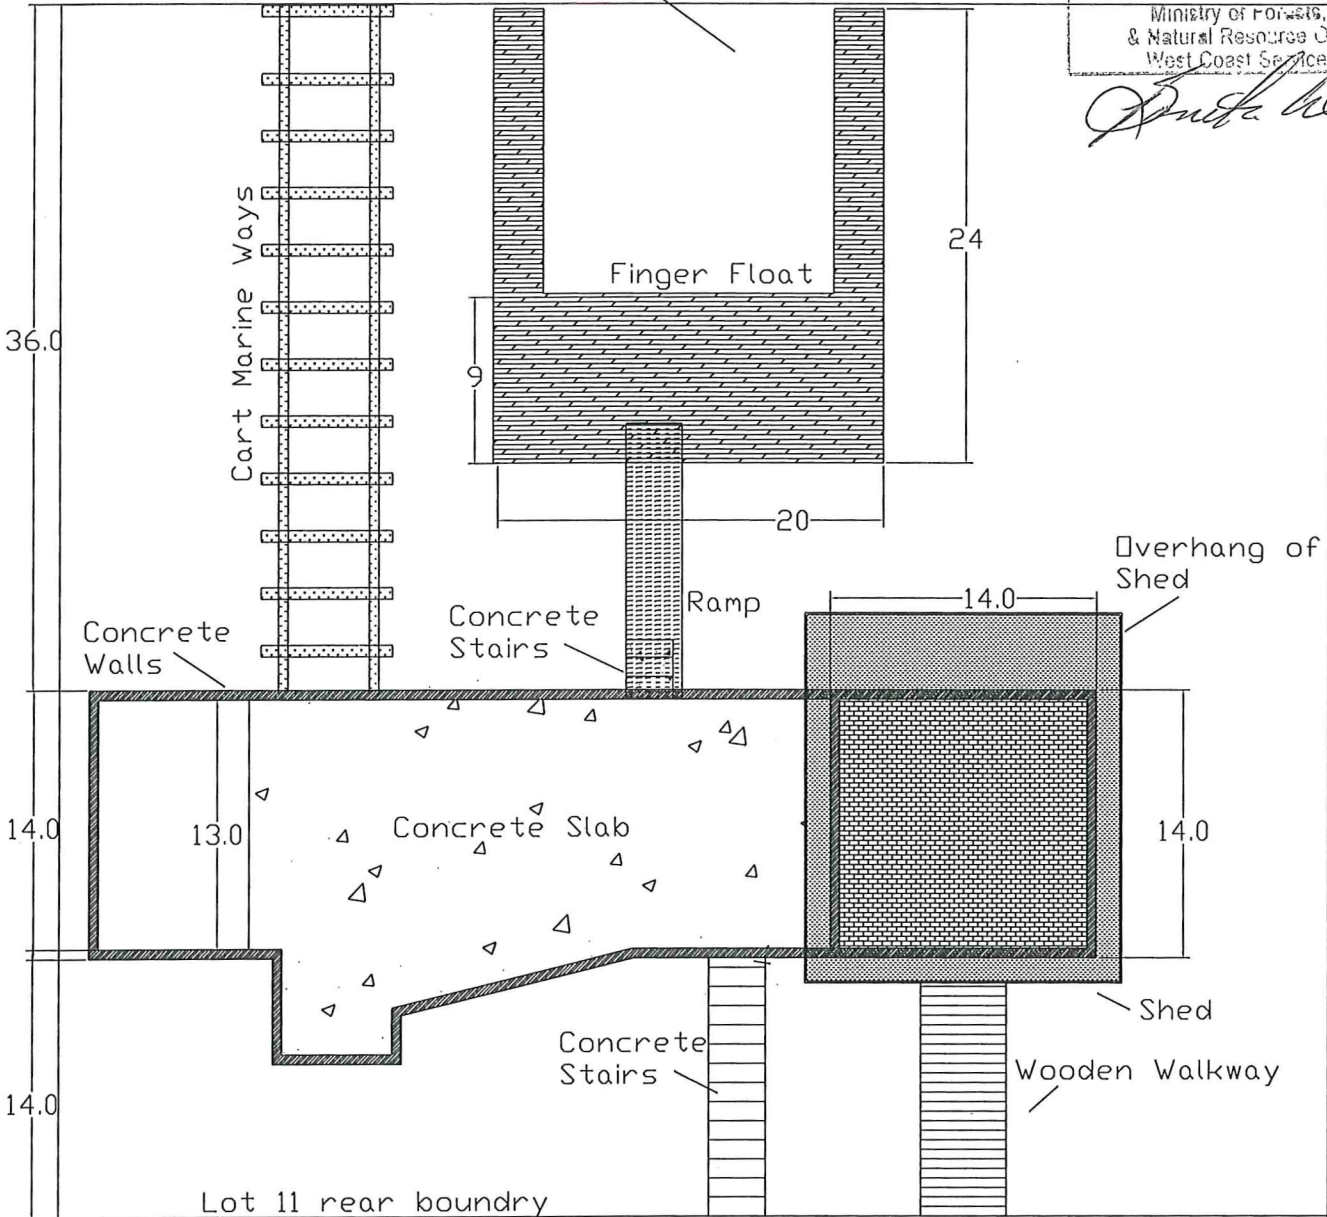

Condensed for printing purposes

175'

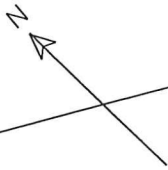

Legal Description: Lot 11, Block 49,  
 Section 1, Nanaimo Land District 32, Plan 584  
 Foreshore Lease: C-81374005  
 Dimensions in imperial  
 Scale 1 to 10  
 As-built  
 Drawn by: Mario Maibach  
 August 24, 2012

RECEIVED  
 AUG 27 2012  
*DP00802*  
 DEVELOPMENT SERVICES  
 CITY OF NANAIMO

177'