


SCHEDULE "A"

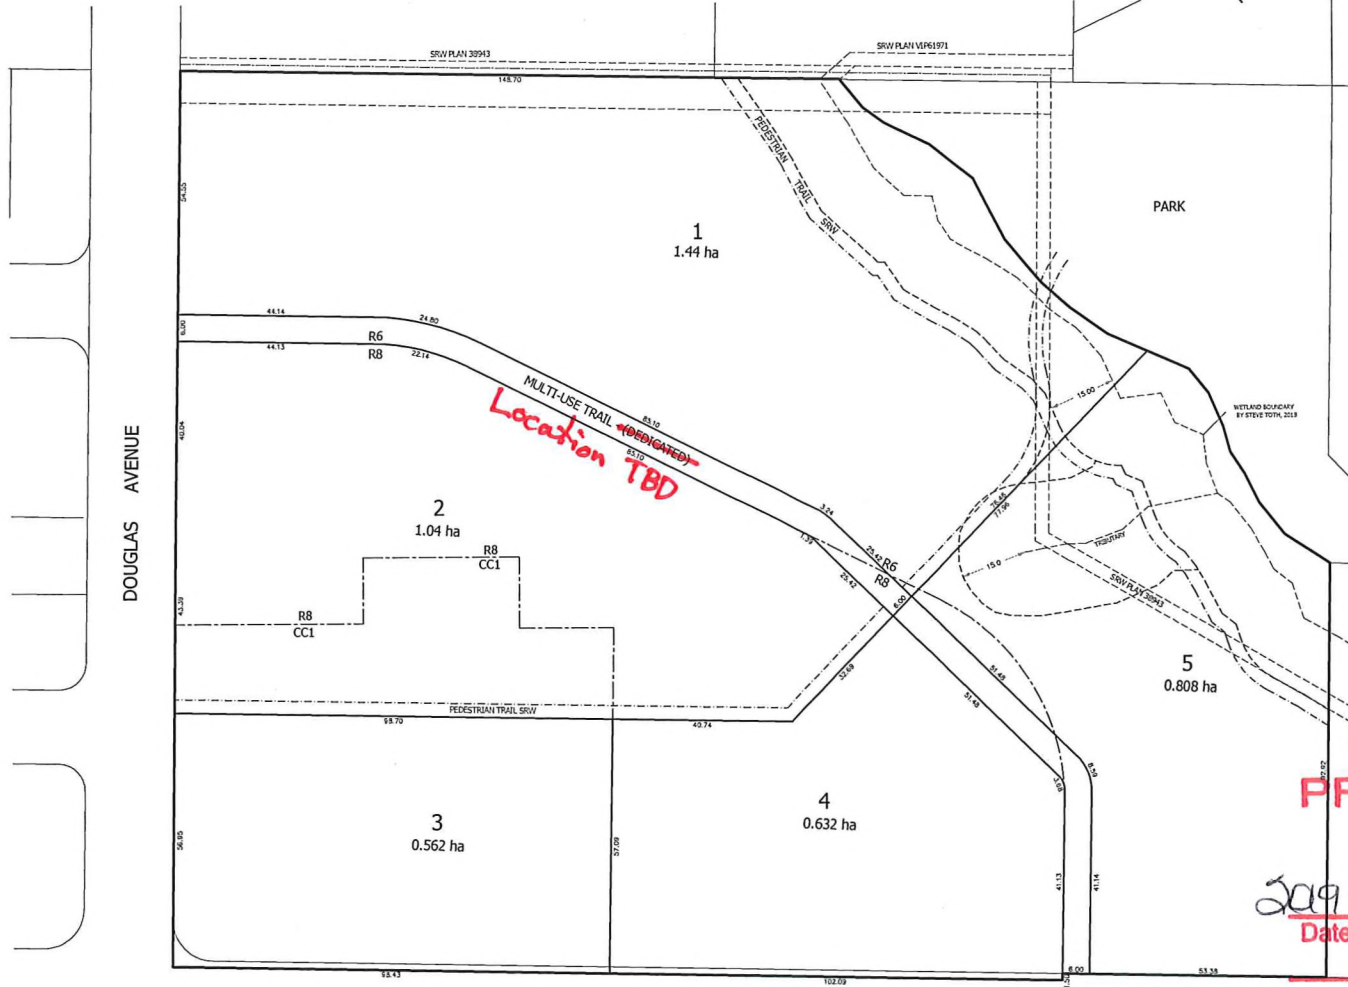

**CITY OF NANAIMO
PRELIMINARY LAYOUT
ACCEPTANCE**

~~2019-JUN-24~~
Date

~~2020-JUN-24~~
Approved By

Expire Date

PROJECT: DOUGLAS AVE. AND 10TH STREET
 CLIENT: 533 ALPINE INVESTMENTS LTD.
 INC. No. 0779099
 DRAWING: PRELIMINARY LAYOUT APPROVAL

NO.	DATE	REVISION
02	NOV 28, 2017	FIRST ISSUE
01	JAN 12, 2018	CHANGES TO LOT DESIGN
03	JUNE 28, 2018	CHANGES TO LOT DESIGN
04	OCT 04, 2018	CHANGES TO LOT DESIGN
05	FEB 04, 2019	CHANGES TO LOT DESIGN

DATE: NOV 23/17
 SCALE: 1:500
 DRAWN: CH
 FILE: 17096-5
 SHEET: 1 OF 1

**WILLIAMSON & ASSOCIATES
PROFESSIONAL SURVEYORS**
 3518 BAYVIEW ROAD NANAIMO B.C. V9T 4E5
 PHONE: (250) 756-7123 FAX/EMAIL: (250) 756-7724
 EMAIL: WAPS@TELUS.NET

DOUGLAS AVENUE

TENTH STREET