


2  
3  
PROPOSED WEST ELEVATION  
SCALE: 1/4" = 1'-0"

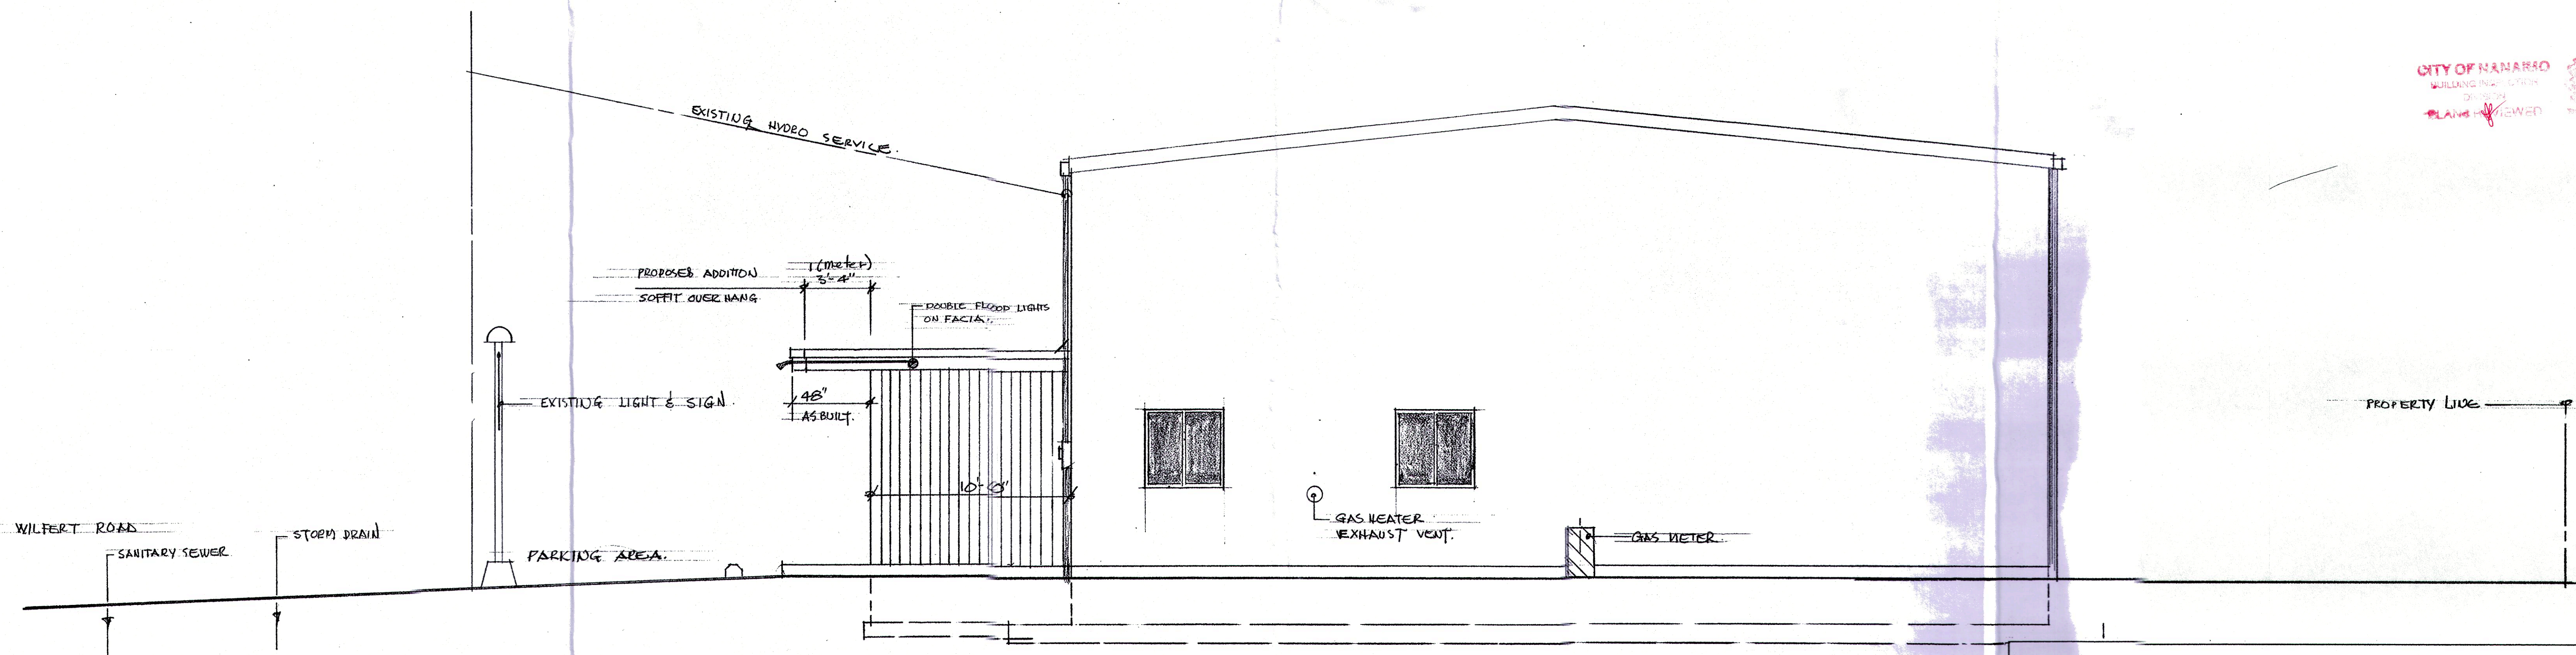

1  
3  
AS-BUILT WEST ELEVATION  
SCALE: 1/4" = 1'-0"

CITY OF NANAIMO  
BUILDING DEPARTMENT  
PLANS REVIEWED

<ul style="list-style-type: none"> <li>DESIGN PROPOSALS</li> <li>PLANS DRAFTED TO SCALE</li> <li>LAND USE STUDIES</li> <li>MATERIAL LISTS</li> <li>A SKETCH OF YOUR HOME</li> </ul>		DRWG. NO. 120918 DATE: OCT/12 SCALE: AS SHOWN APPROVED:
250-228-5900 <b>VILLAGE design &amp; drafting</b>		SHEET 8/
ADDITION, BATHROOMS, OFFICE, FIRE EXITS 1911 WILFERT ROAD, NANAIMO, BC		

