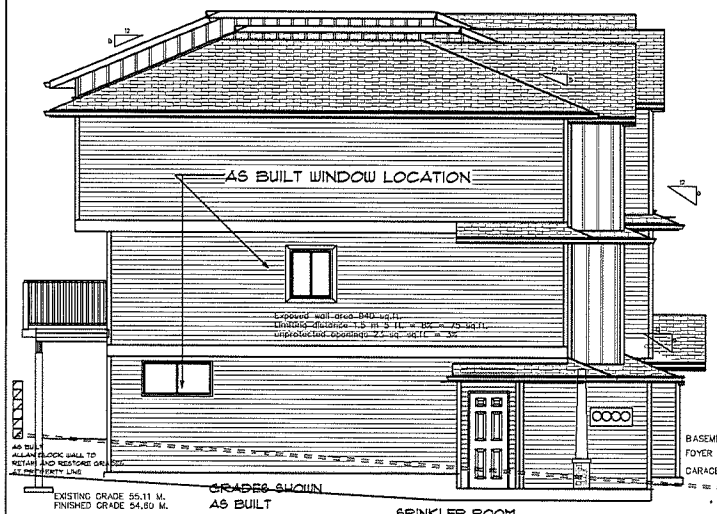

LEFT ELEVATION

SCALE: 1/4" = 1'-0"

SRINKLER ROOM
AS BUILT
REPLACE DOOR TO MATCH
APPROVED D.P.

EXISTING GRADE 54.67 M.
FINISHED GRADE 53.90 M.

ADD GLAZING TO
GARAGE DOOR TO MATCH
APPROVED D.P.

FRONT ELEVATION

SCALE: 1/4" = 1'-0"

BUILDING #2 WITH UNITS #4 #5 #6

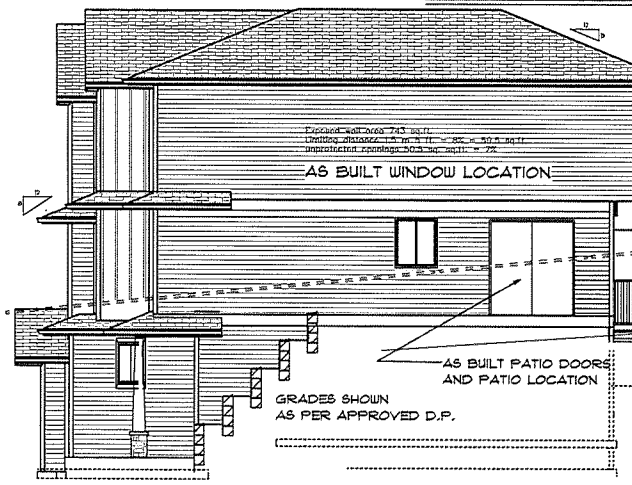

RIGHT ELEVATION

SCALE: 1/4" = 1'-0"

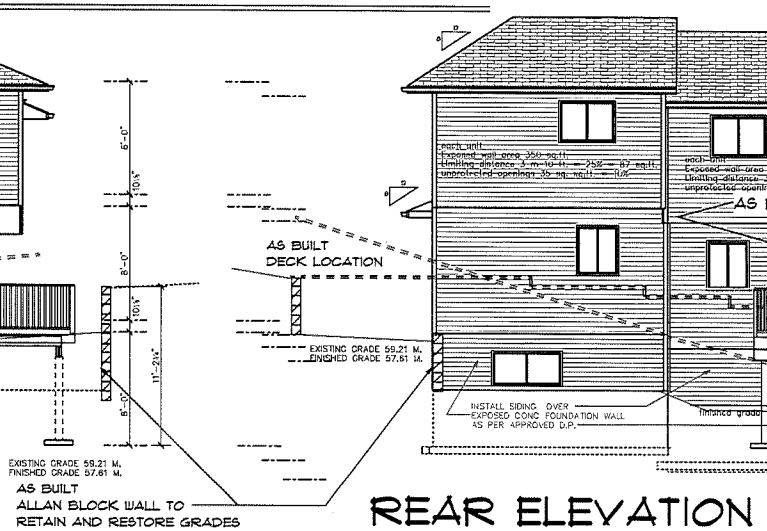

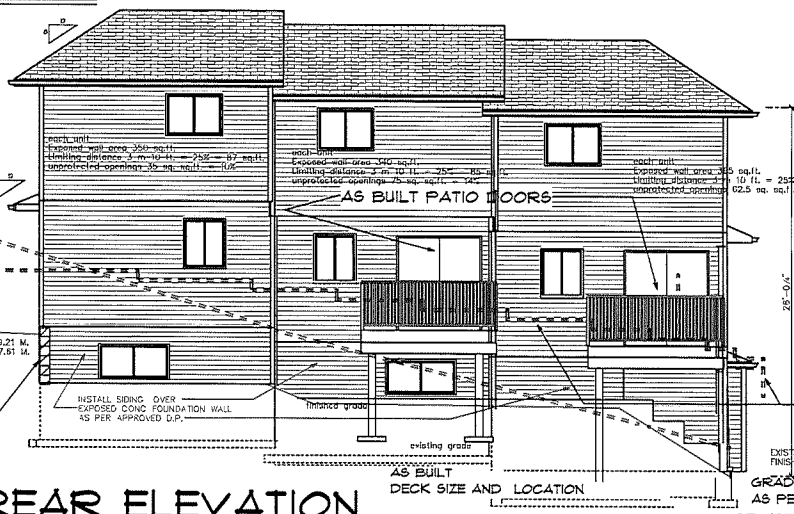

REAR ELEVATION

SCALE: 1/4" = 1'-0"

RECEIVED
DP000755
2017-MAR-30

REVISED MAR 25TH 2016

STRAIGHT STREET DESIGN RESERVES THE RIGHT TO LIMIT 1 COPY OF 1 SET OF PLANS FOR ONE HOUSE THAT IS TO BE TO BE CONSTRUCTED ON CLIENTS LOT.

COPYRIGHT RESERVED.
THIS PLAN AND DESIGN IS AT ALL TIMES REMAINS THE EXCLUSIVE PROPERTY OF KENNETH BRAULT, STRAIGHT STREET DESIGN AND CANNOT BE REPRODUCED IN ANY MANNER, MECHANICAL OR REPRINT, OR USED IN ANY MANNER WITHOUT WRITTEN PERMISSION FROM THE AUTHOR.

Straight Street Design * From Drains to Beams
1194 COLLEGE Dr. NANAIMO B.C. V9R-6A4 250-753 9958 Kenneth Brault

PROJECT
10 unit Multi family Project *3217 Hammond Bay Rd.

DRAWING TITLE

SCALE: as noted | DATE | DRAWN BY: K.N.B. | REVISED

DRAWING NUMBER
A-5